


0260-169  
RECORD PLAN  
Scale 8 feet to an inch

K-21

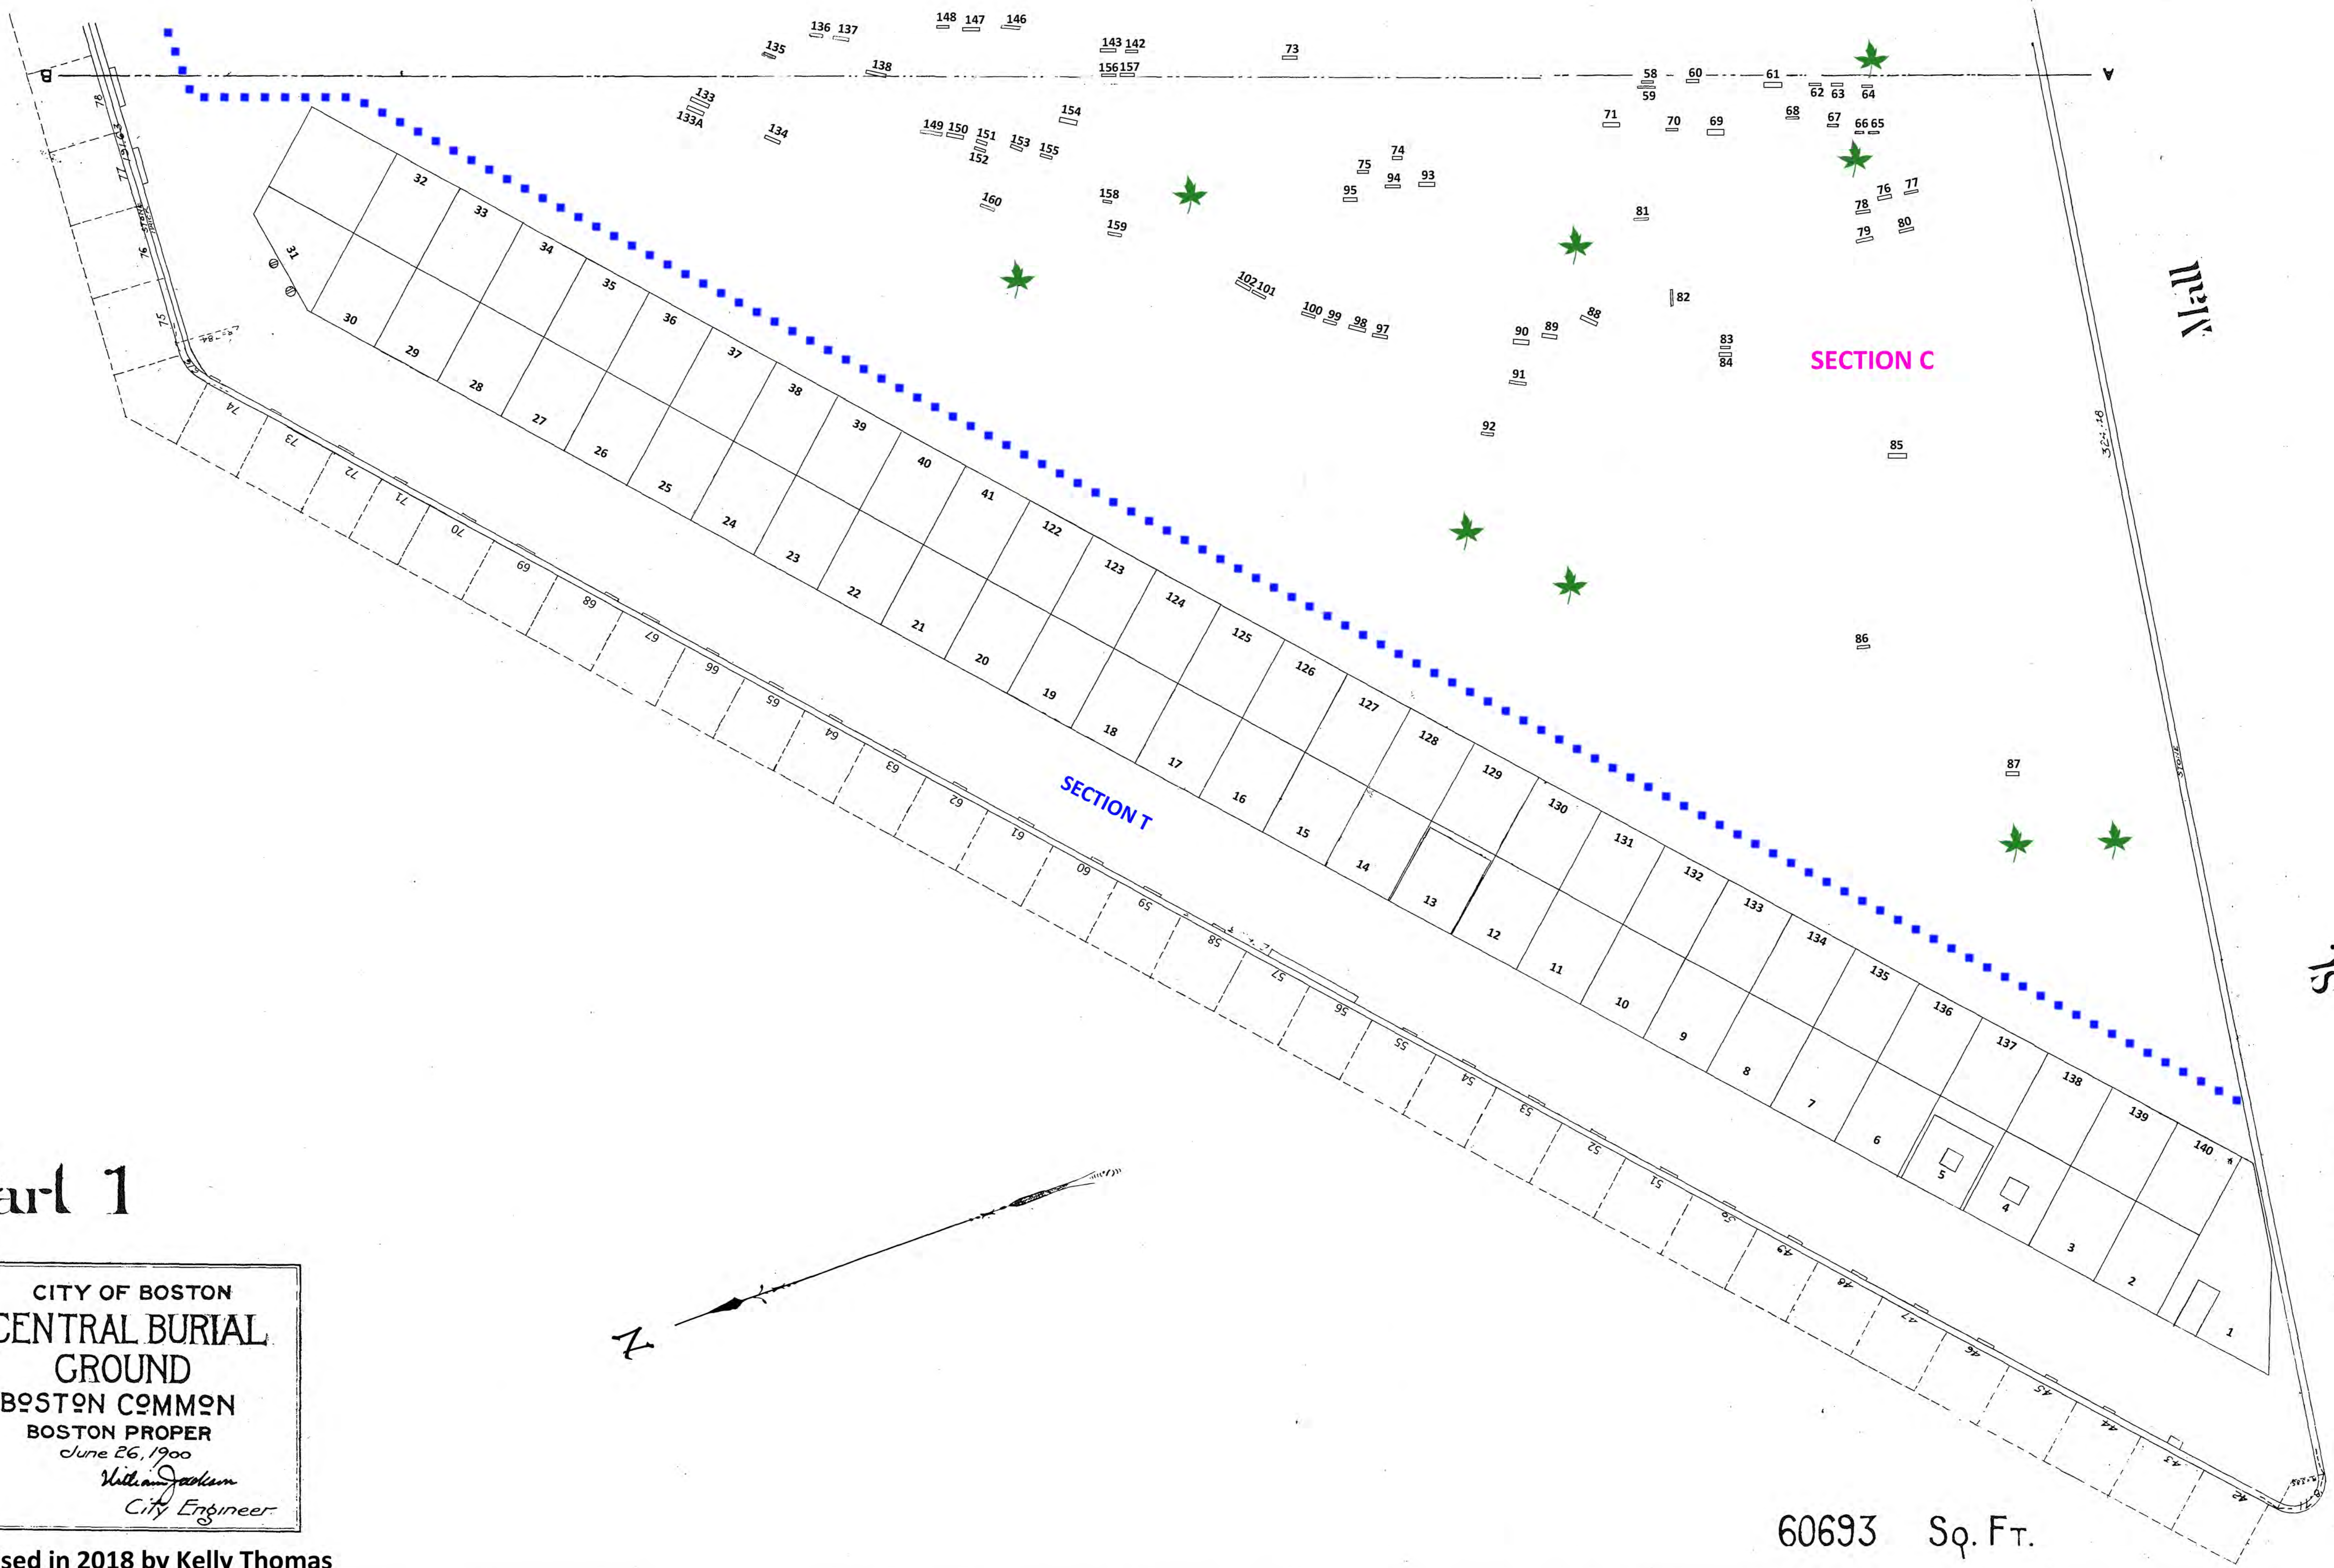

# Part 1

CITY OF BOSTON  
CENTRAL BURIAL  
GROUND  
BOSTON COMMON  
BOSTON PROPER  
June 26, 1900  
*William Jackson*  
City Engineer

Revised in 2018 by Kelly Thomas

60693 Sq. Ft.