



Reg Stamp Location



PAGE INFORMATION  
DRAWINGS

PRINT DATE  
10/23/2019

ISSUE DATE  
# Issue Date

PROJECT NAME  
60 Chestnut Street  
UNIT

PROJECT ADDRESS  
60 Chestnut Street  
Boston, MA

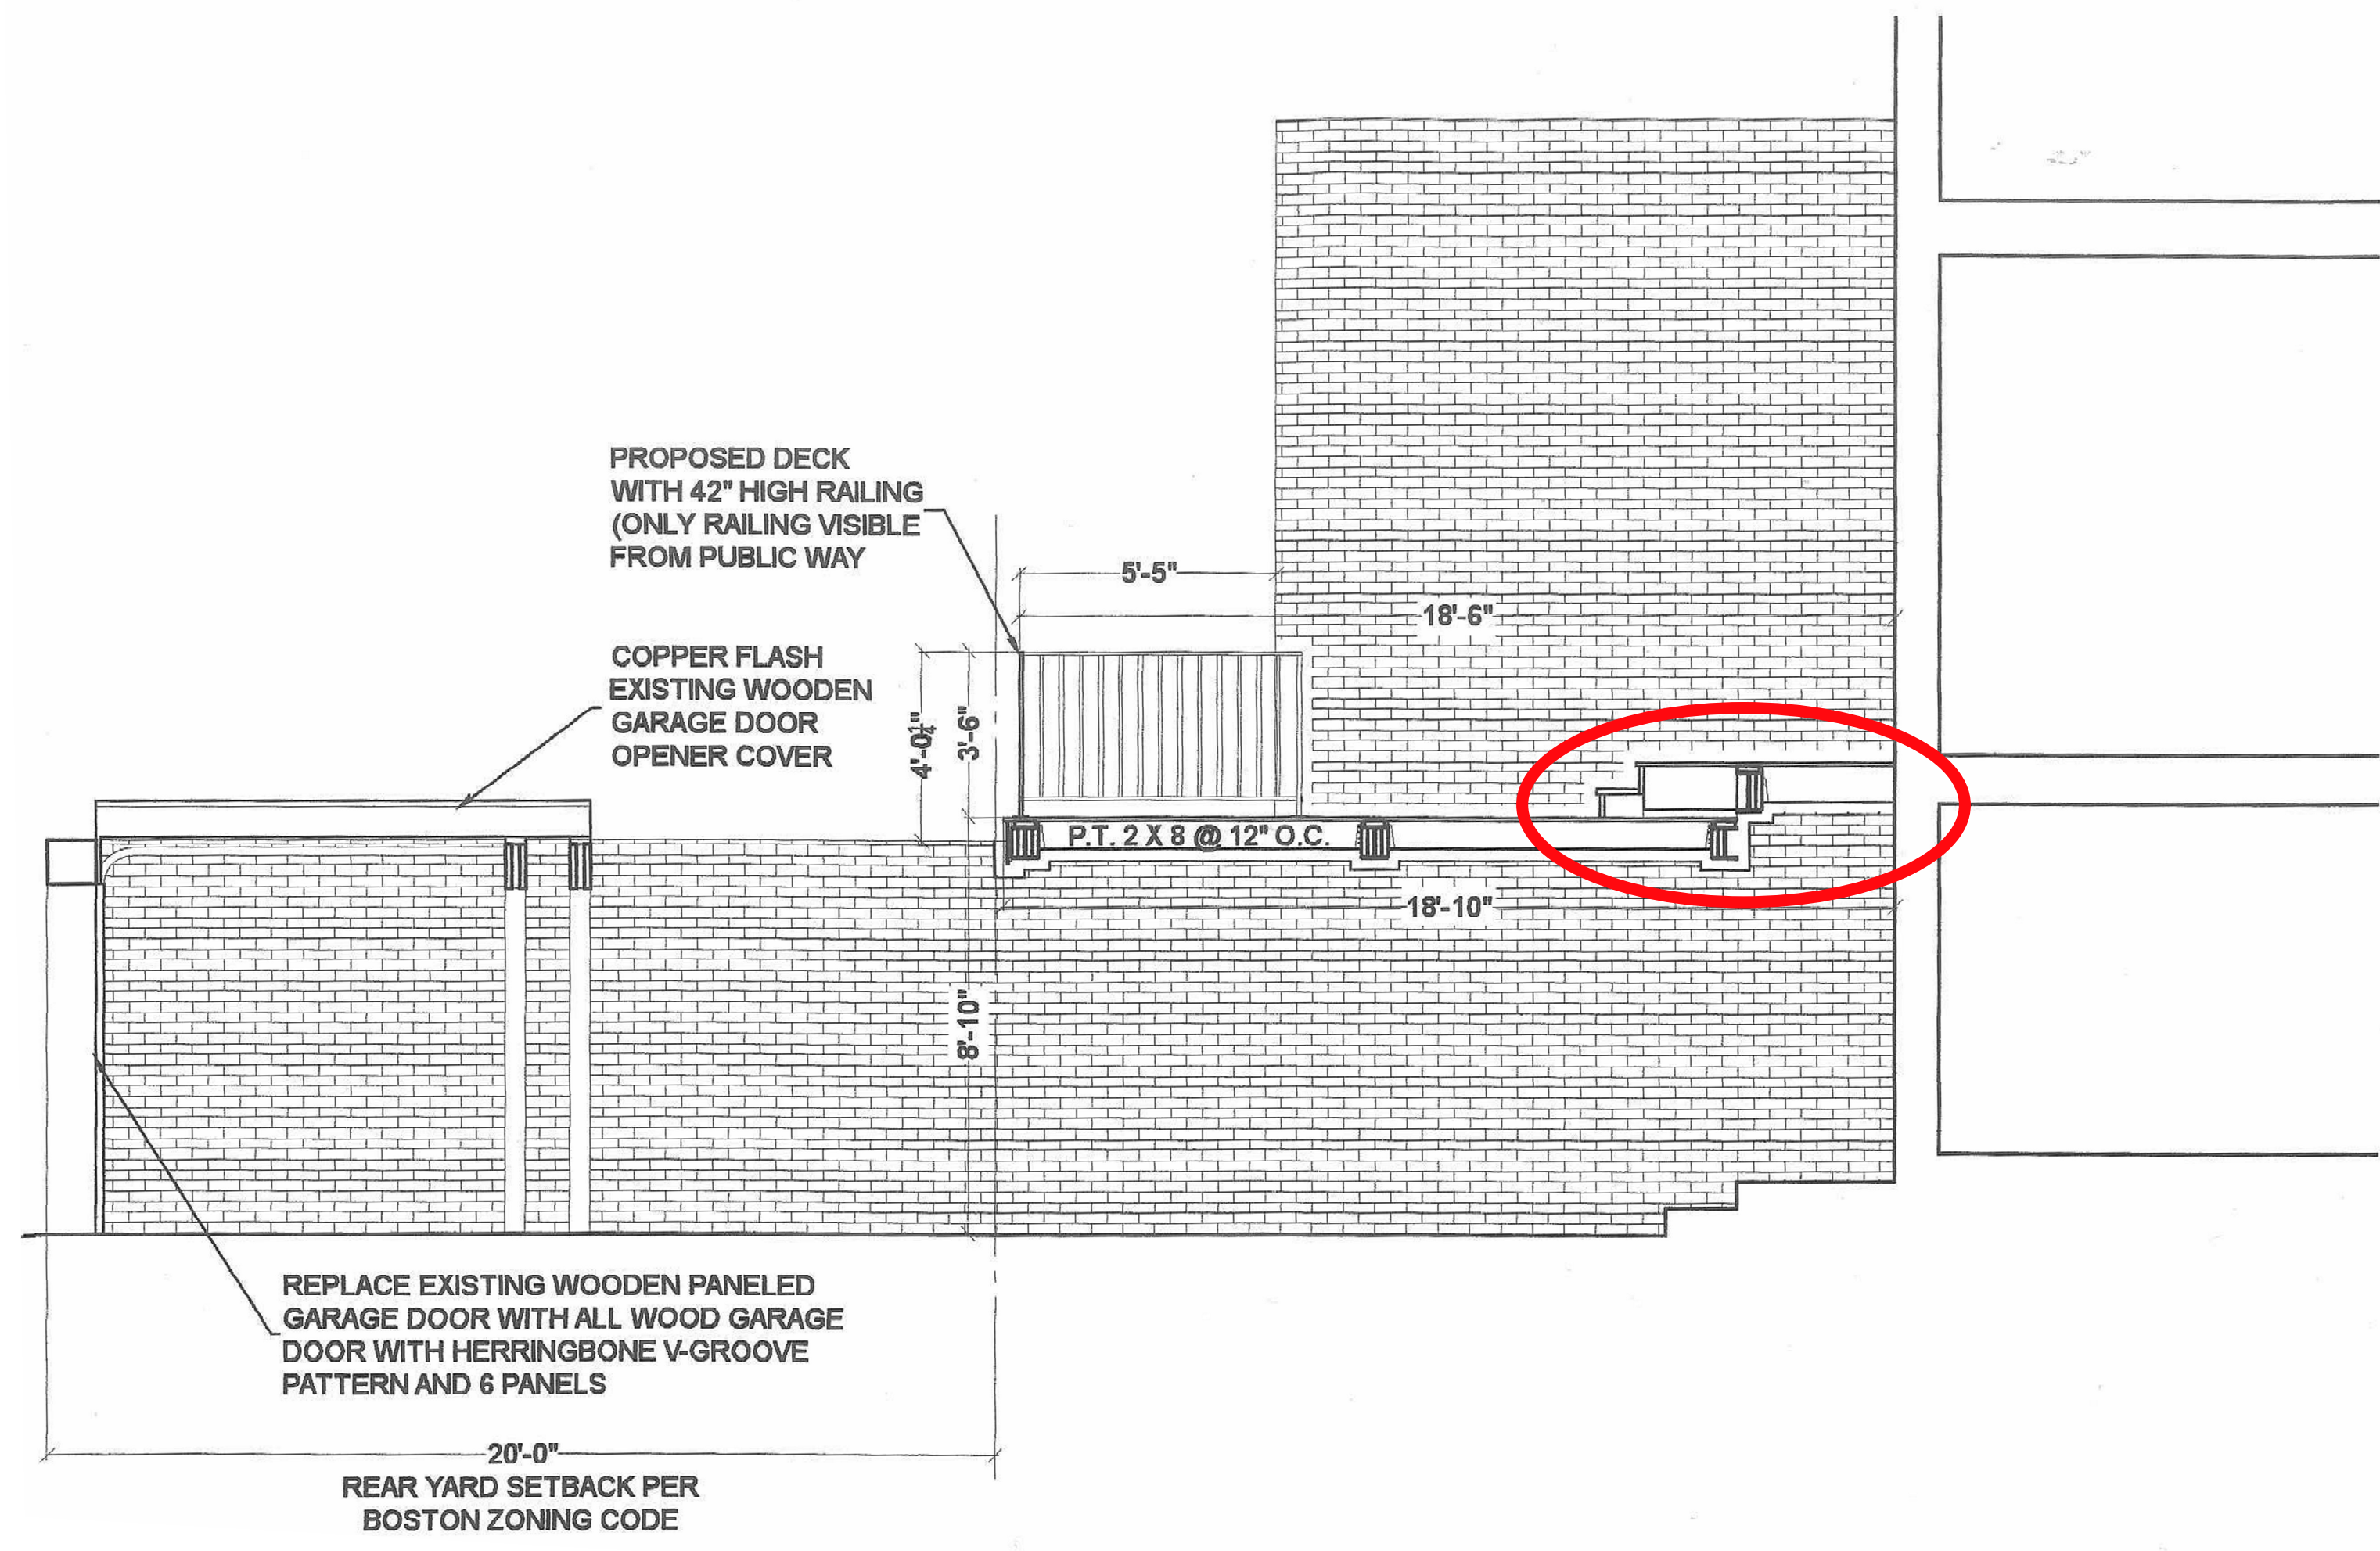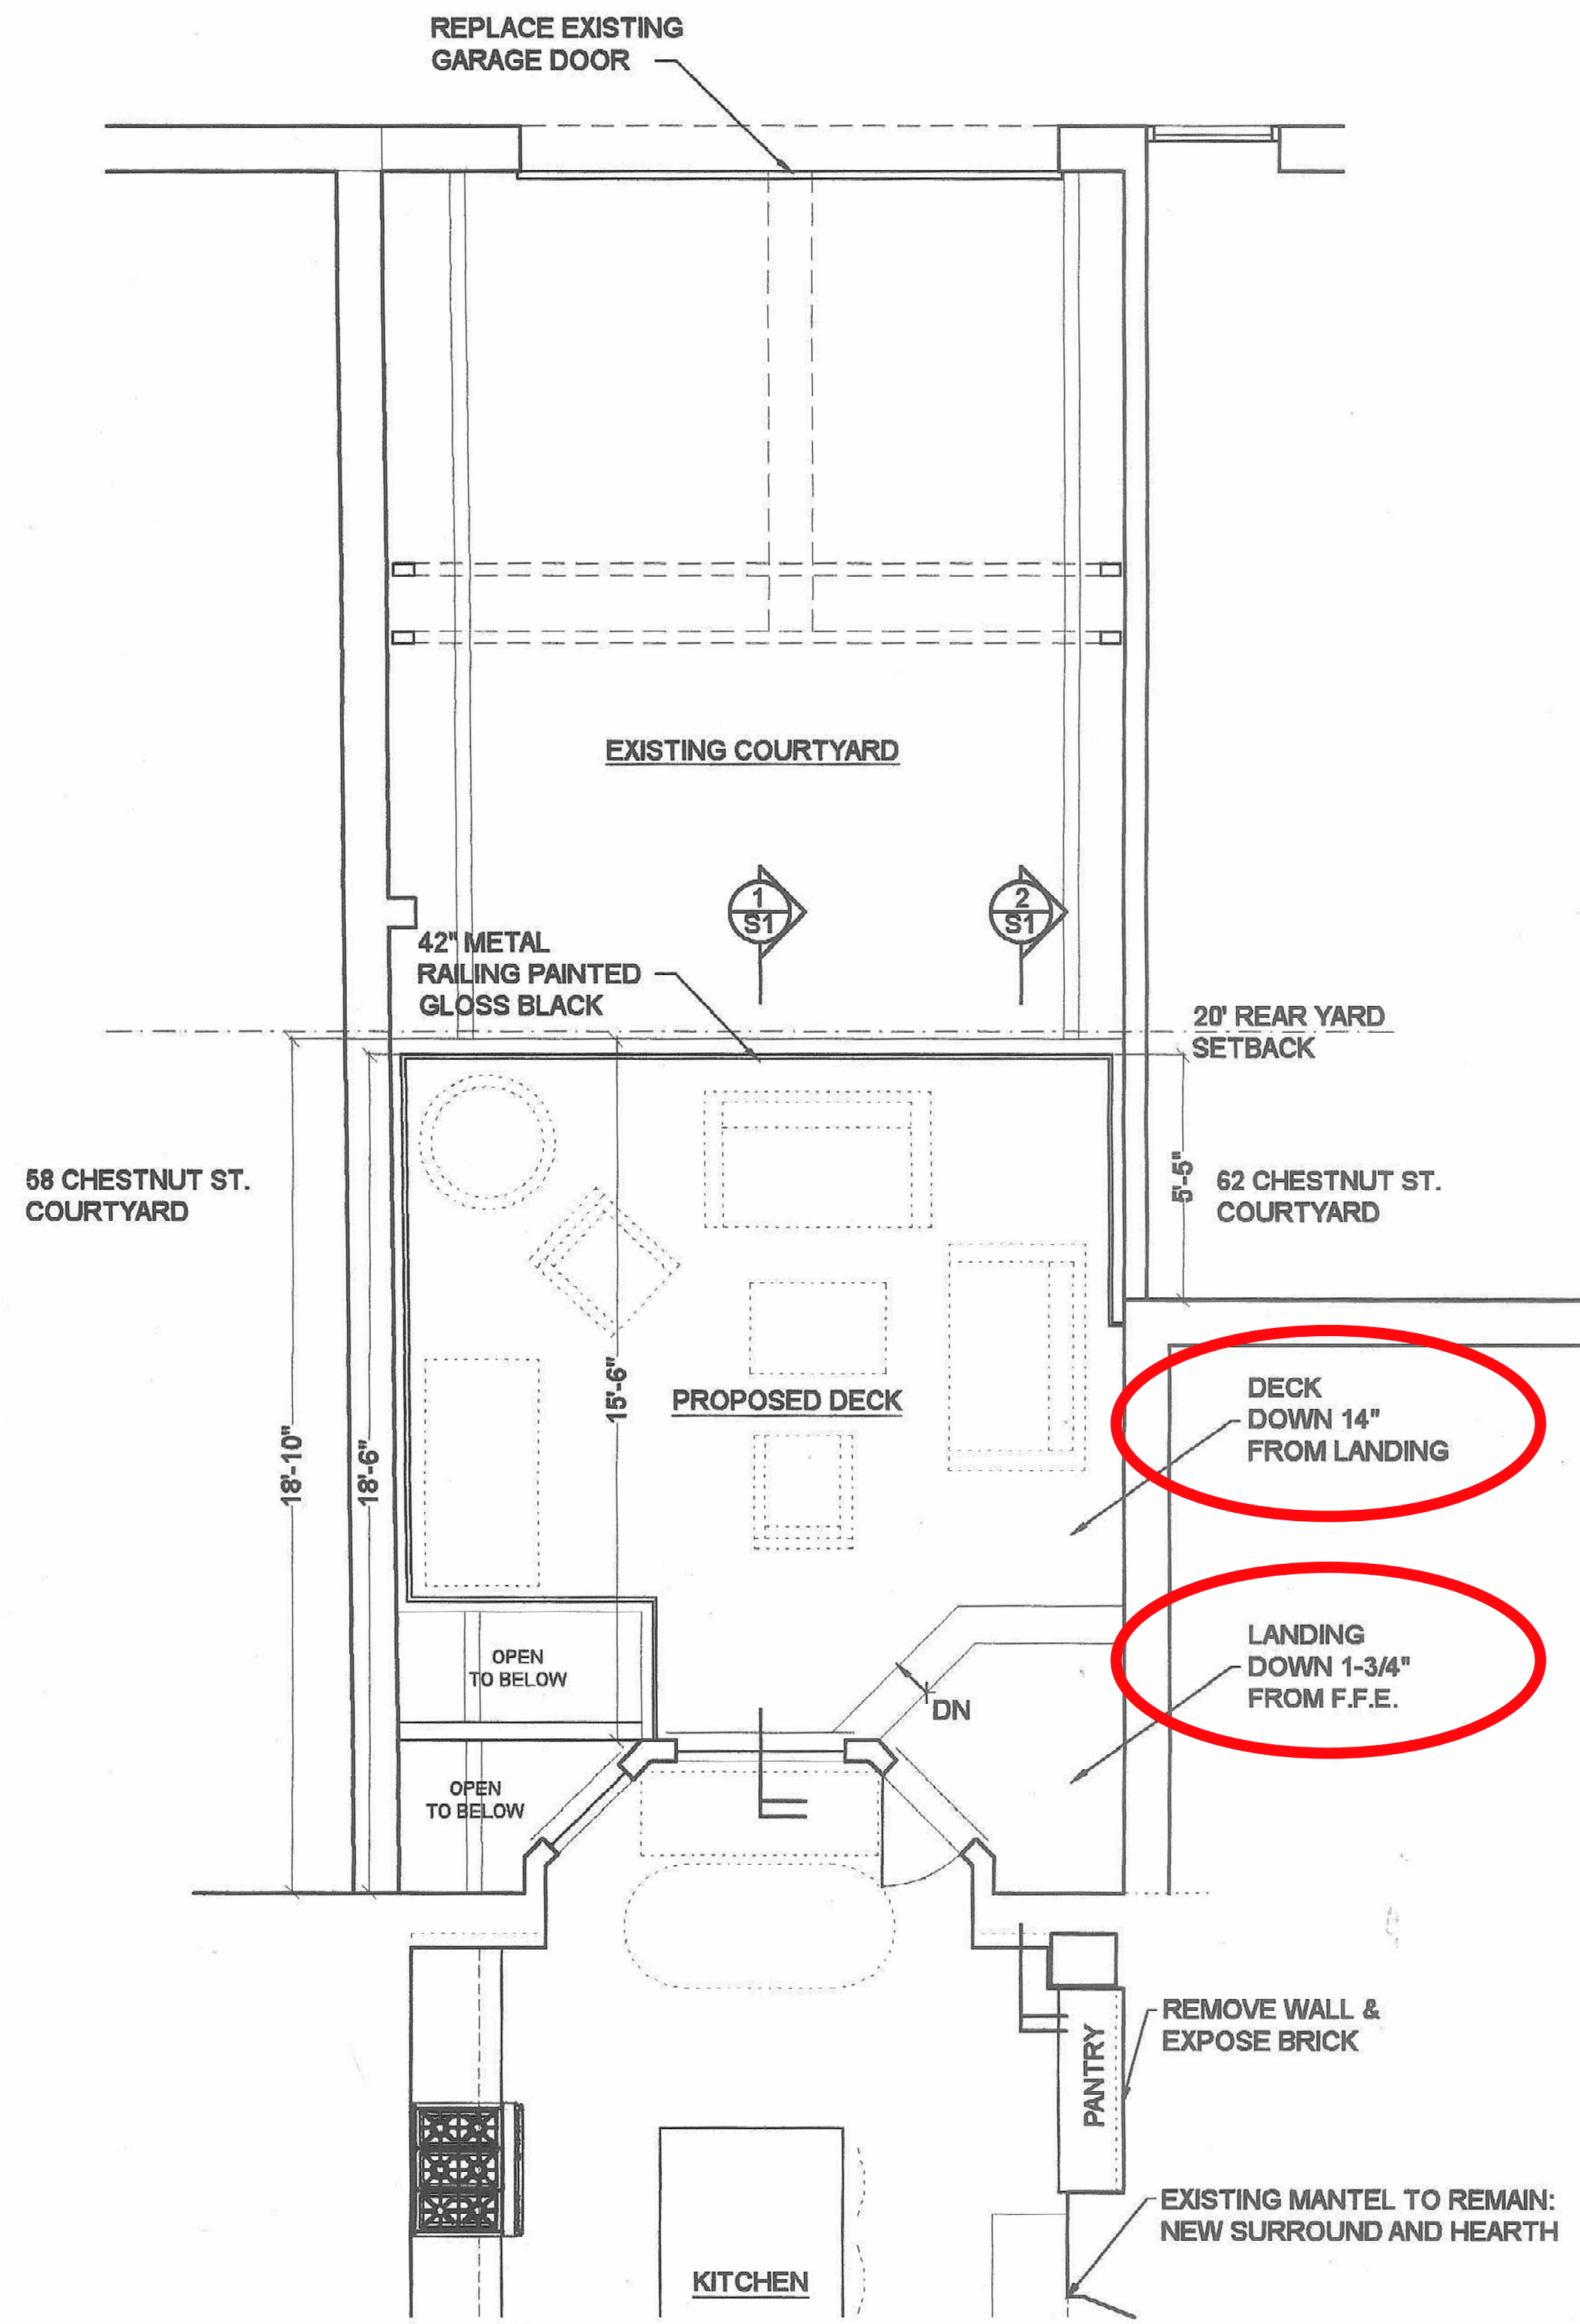

SECTION FROM PREVIOUS DECK

<b>H2</b>	SCALE: 1/4" = 1'-0"	40 RIVER STREET BOSTON, MA 02108	<b>DNA</b> ARCHITECTURE LLC DUSTIN NOLIN A.I.A.
	DATE: 7/31/2013	voice 781-718-8009 dustin@dna-architecture.com	

FLOOR PLAN FROM PREVIOUS DECK

<b>DNA</b> ARCHITECTURE LLC DUSTIN NOLIN A.I.A.	40 RIVER STREET BOSTON, MA 02108 voice 781-718-8009 dustin@dna-architecture.com
PROPOSED REAR DECK MOLVAR #60 CHESTNUT STREET BOSTON, MA	
SCALE: 1/4" = 1'-0"	
DATE: 7/31/2013	
<b>H6</b>	





# AREAS OF REMEDIATION

## - CONDENSER LOCATION


(location to remain with existing planters used as screening)

- PLANTER WALL (decrease height of large planter box and add railing in front of it)


- DECK HEIGHT Deconstruct entire deck and garage structure. Re-build so that the top of decking is 15.75" below the finished first floor (the same exact height as pre-2016 deck). Modify rear flashing detail similar to the adjacent garage structures on Branch Street

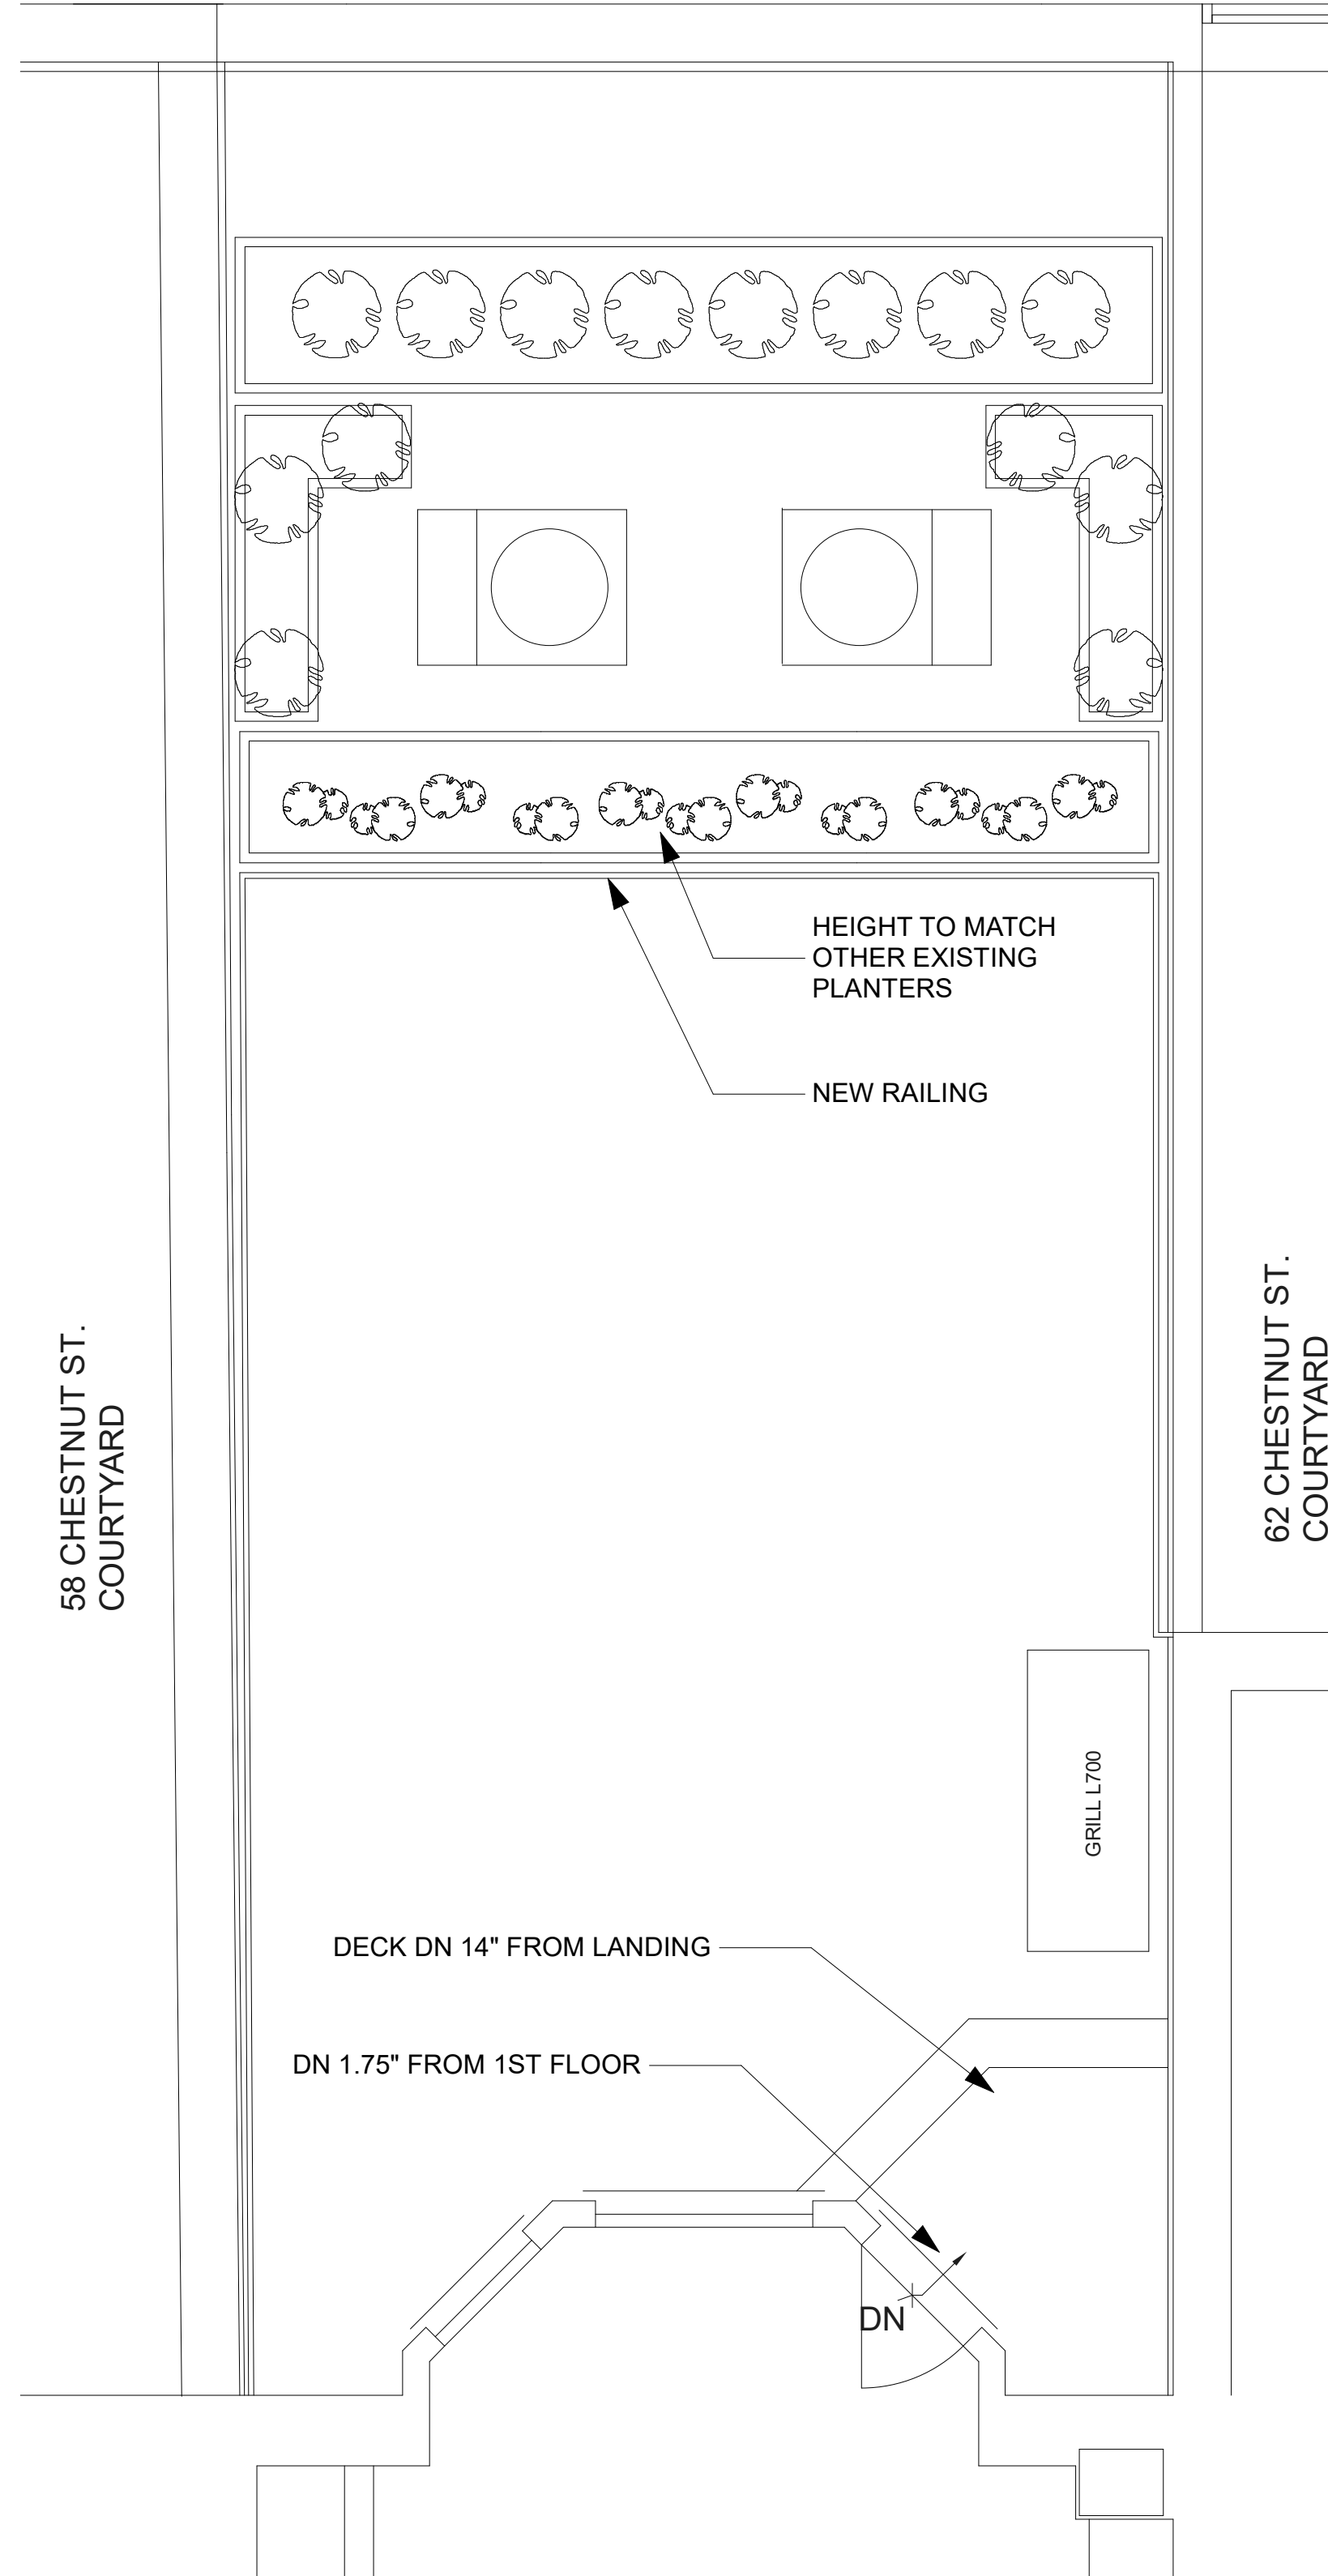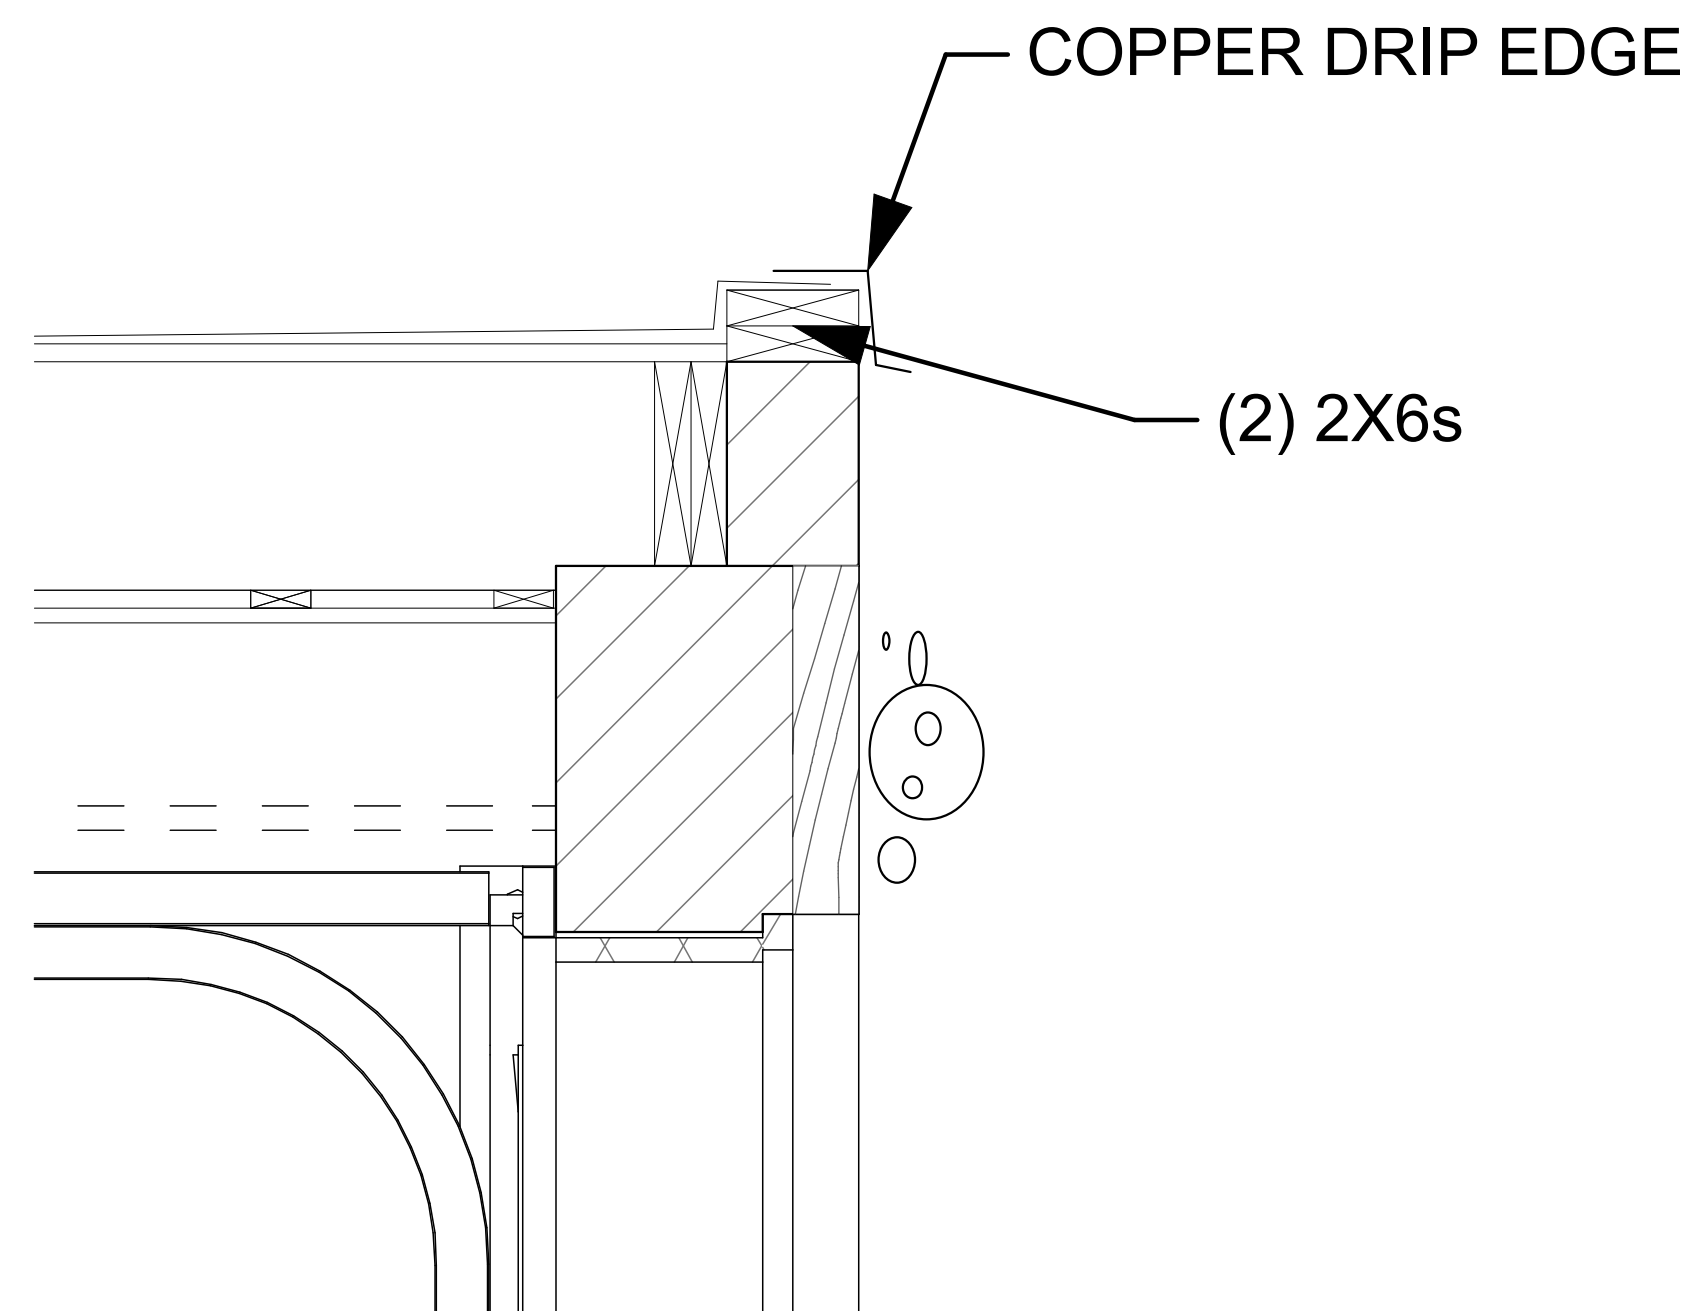

PROPOSED CHANGES

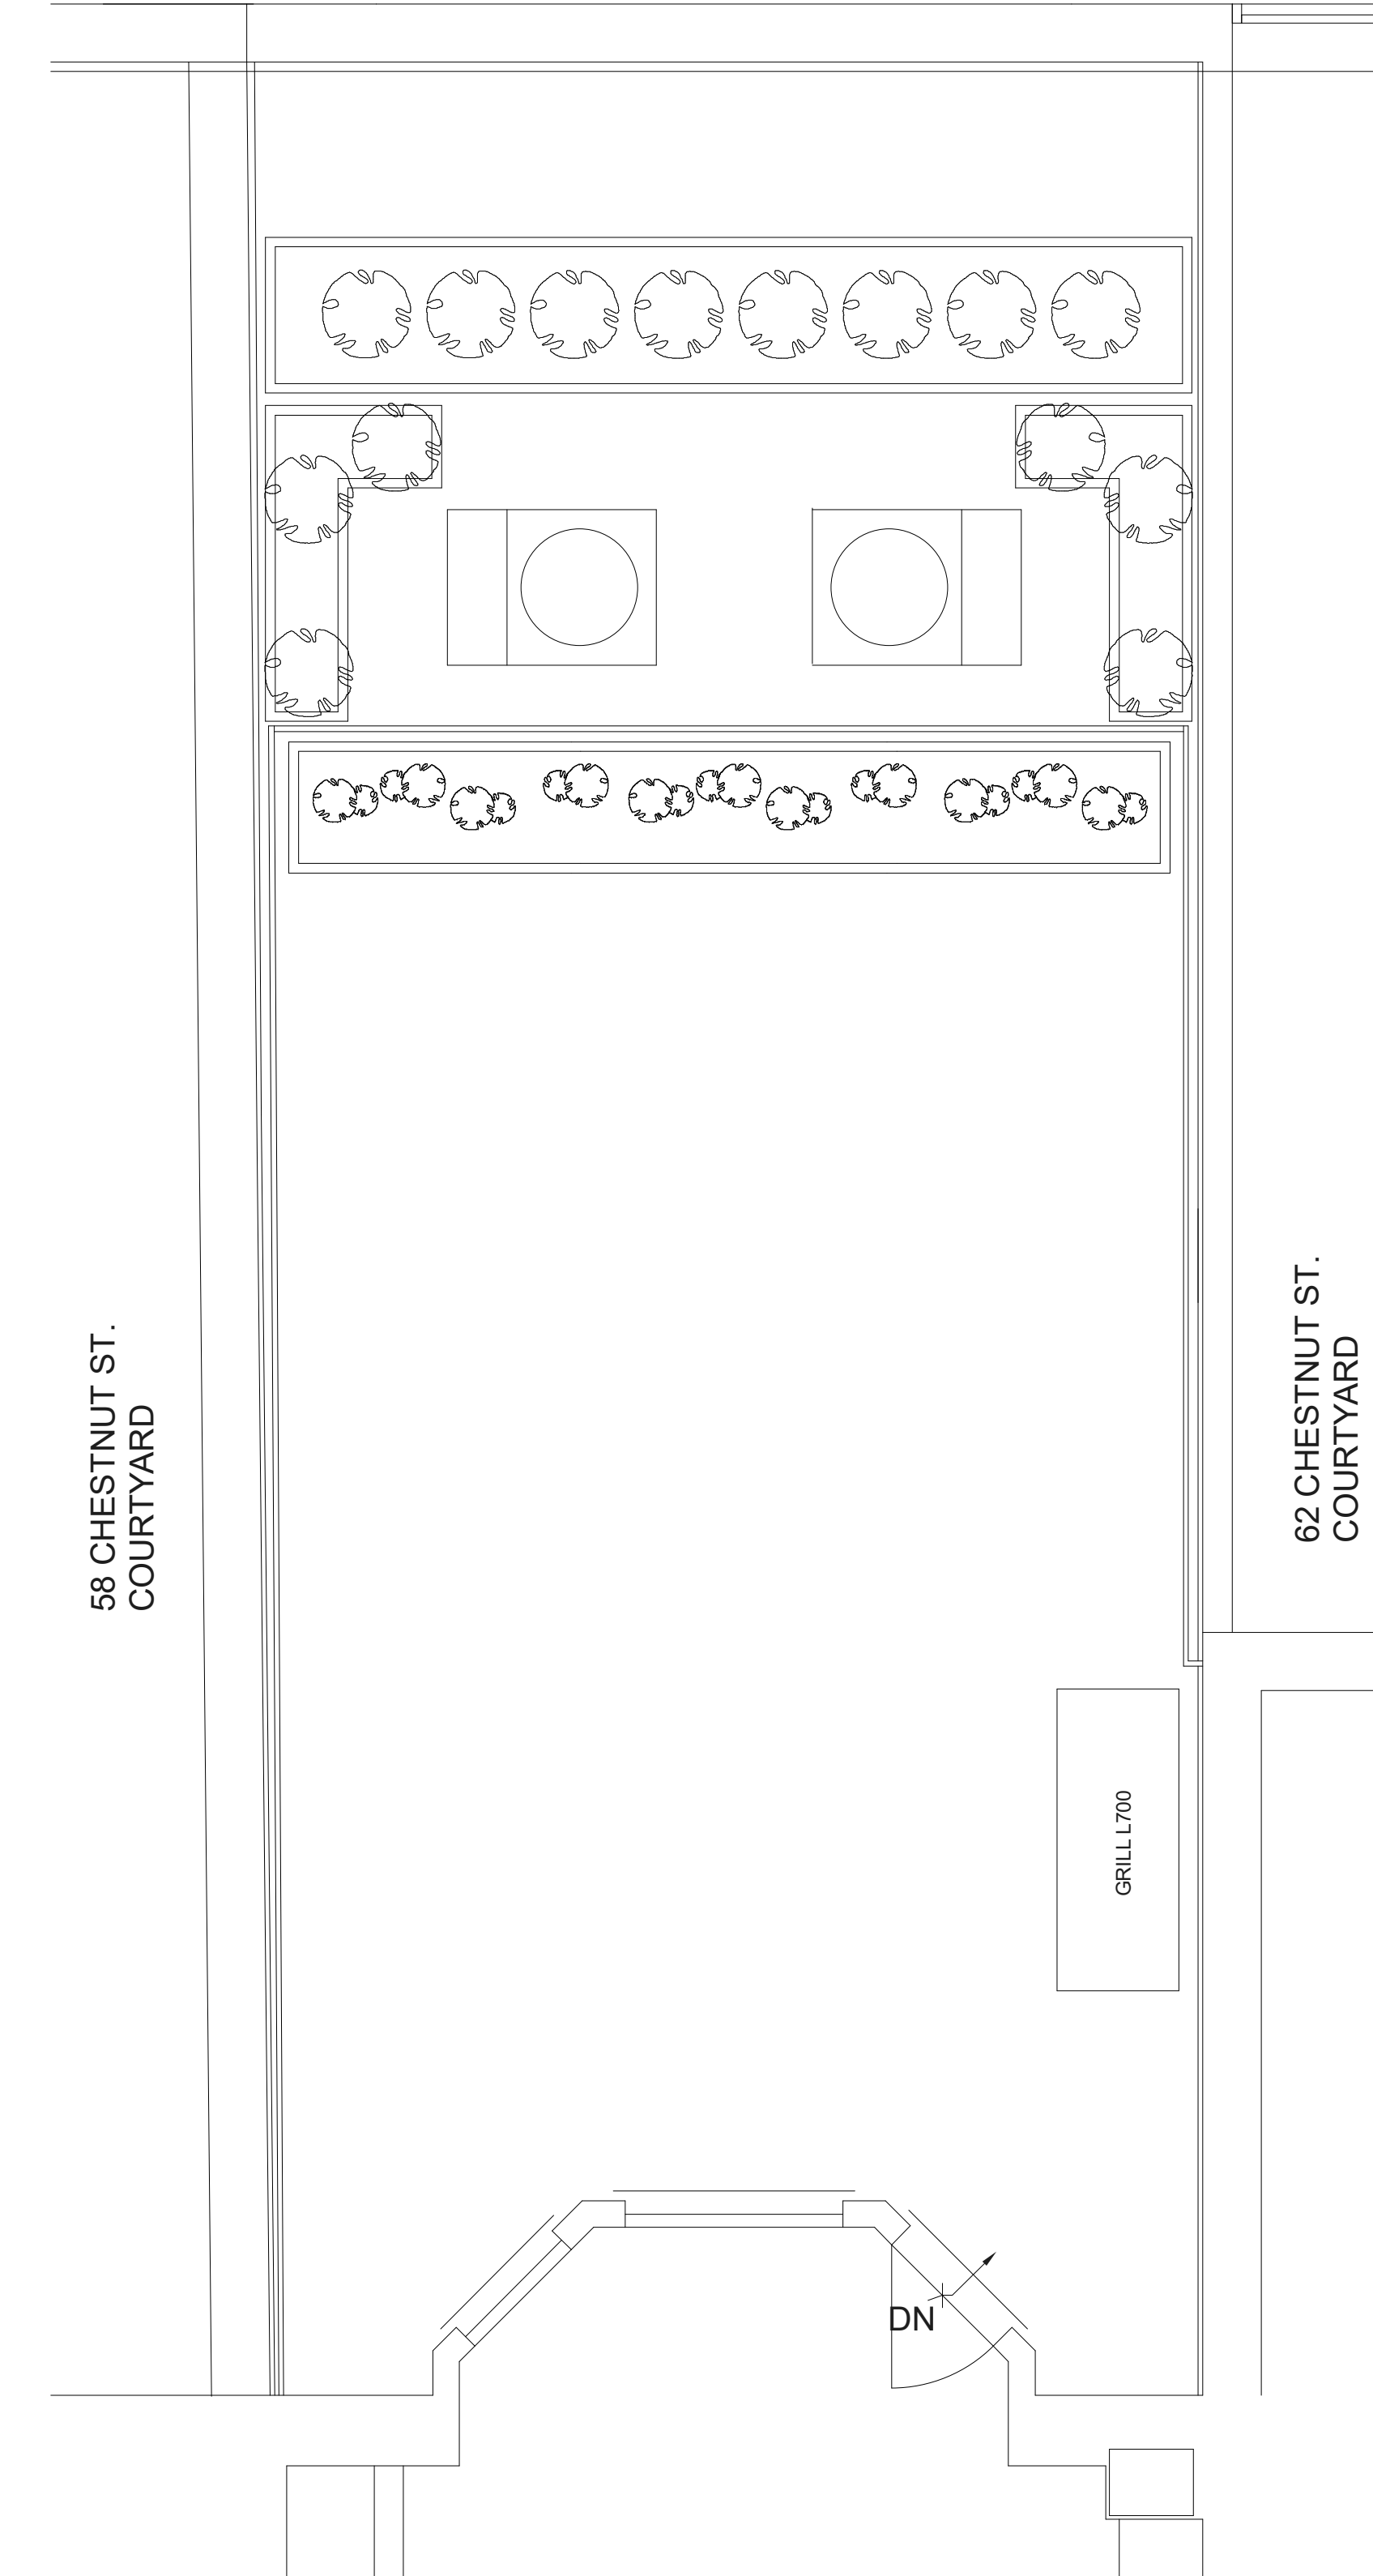

EXISTING AS-BUILT

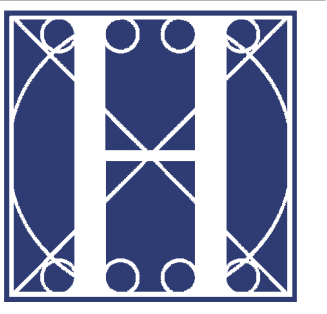

the  
**HOLLAND COMPANIES**  
Design & Construction

1126 Main Street  
Weymouth, MA  
02190

Phone 781.335.4275  
Fax 781.340.0077


thehollandcompanies.com

Reg Stamp Location

PAGE INFORMATION:  
**DRAWINGS**  
REVISION/DATE

PRINT DATE:  
**10/23/2019**  
ISSUE DATE:  
# Issue Date

PROJECT NAME:  
**60 Chestnut Street**  
UNIT:  
PROJECT ADDRESS:  
**60 Chestnut Street  
Boston, Ma**

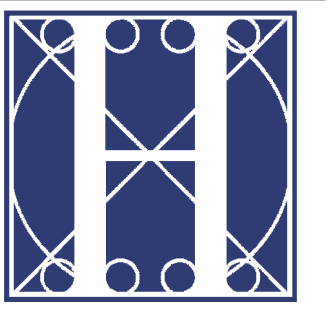


*the*  
**HOLLAND COMPANIES**  
*Design & Construction*

1126 Main Street  
Weymouth, MA  
02190


Phone 781.335.4275  
Fax 781.340.0077

thehollandcompanies.com

Reg Stamp Location

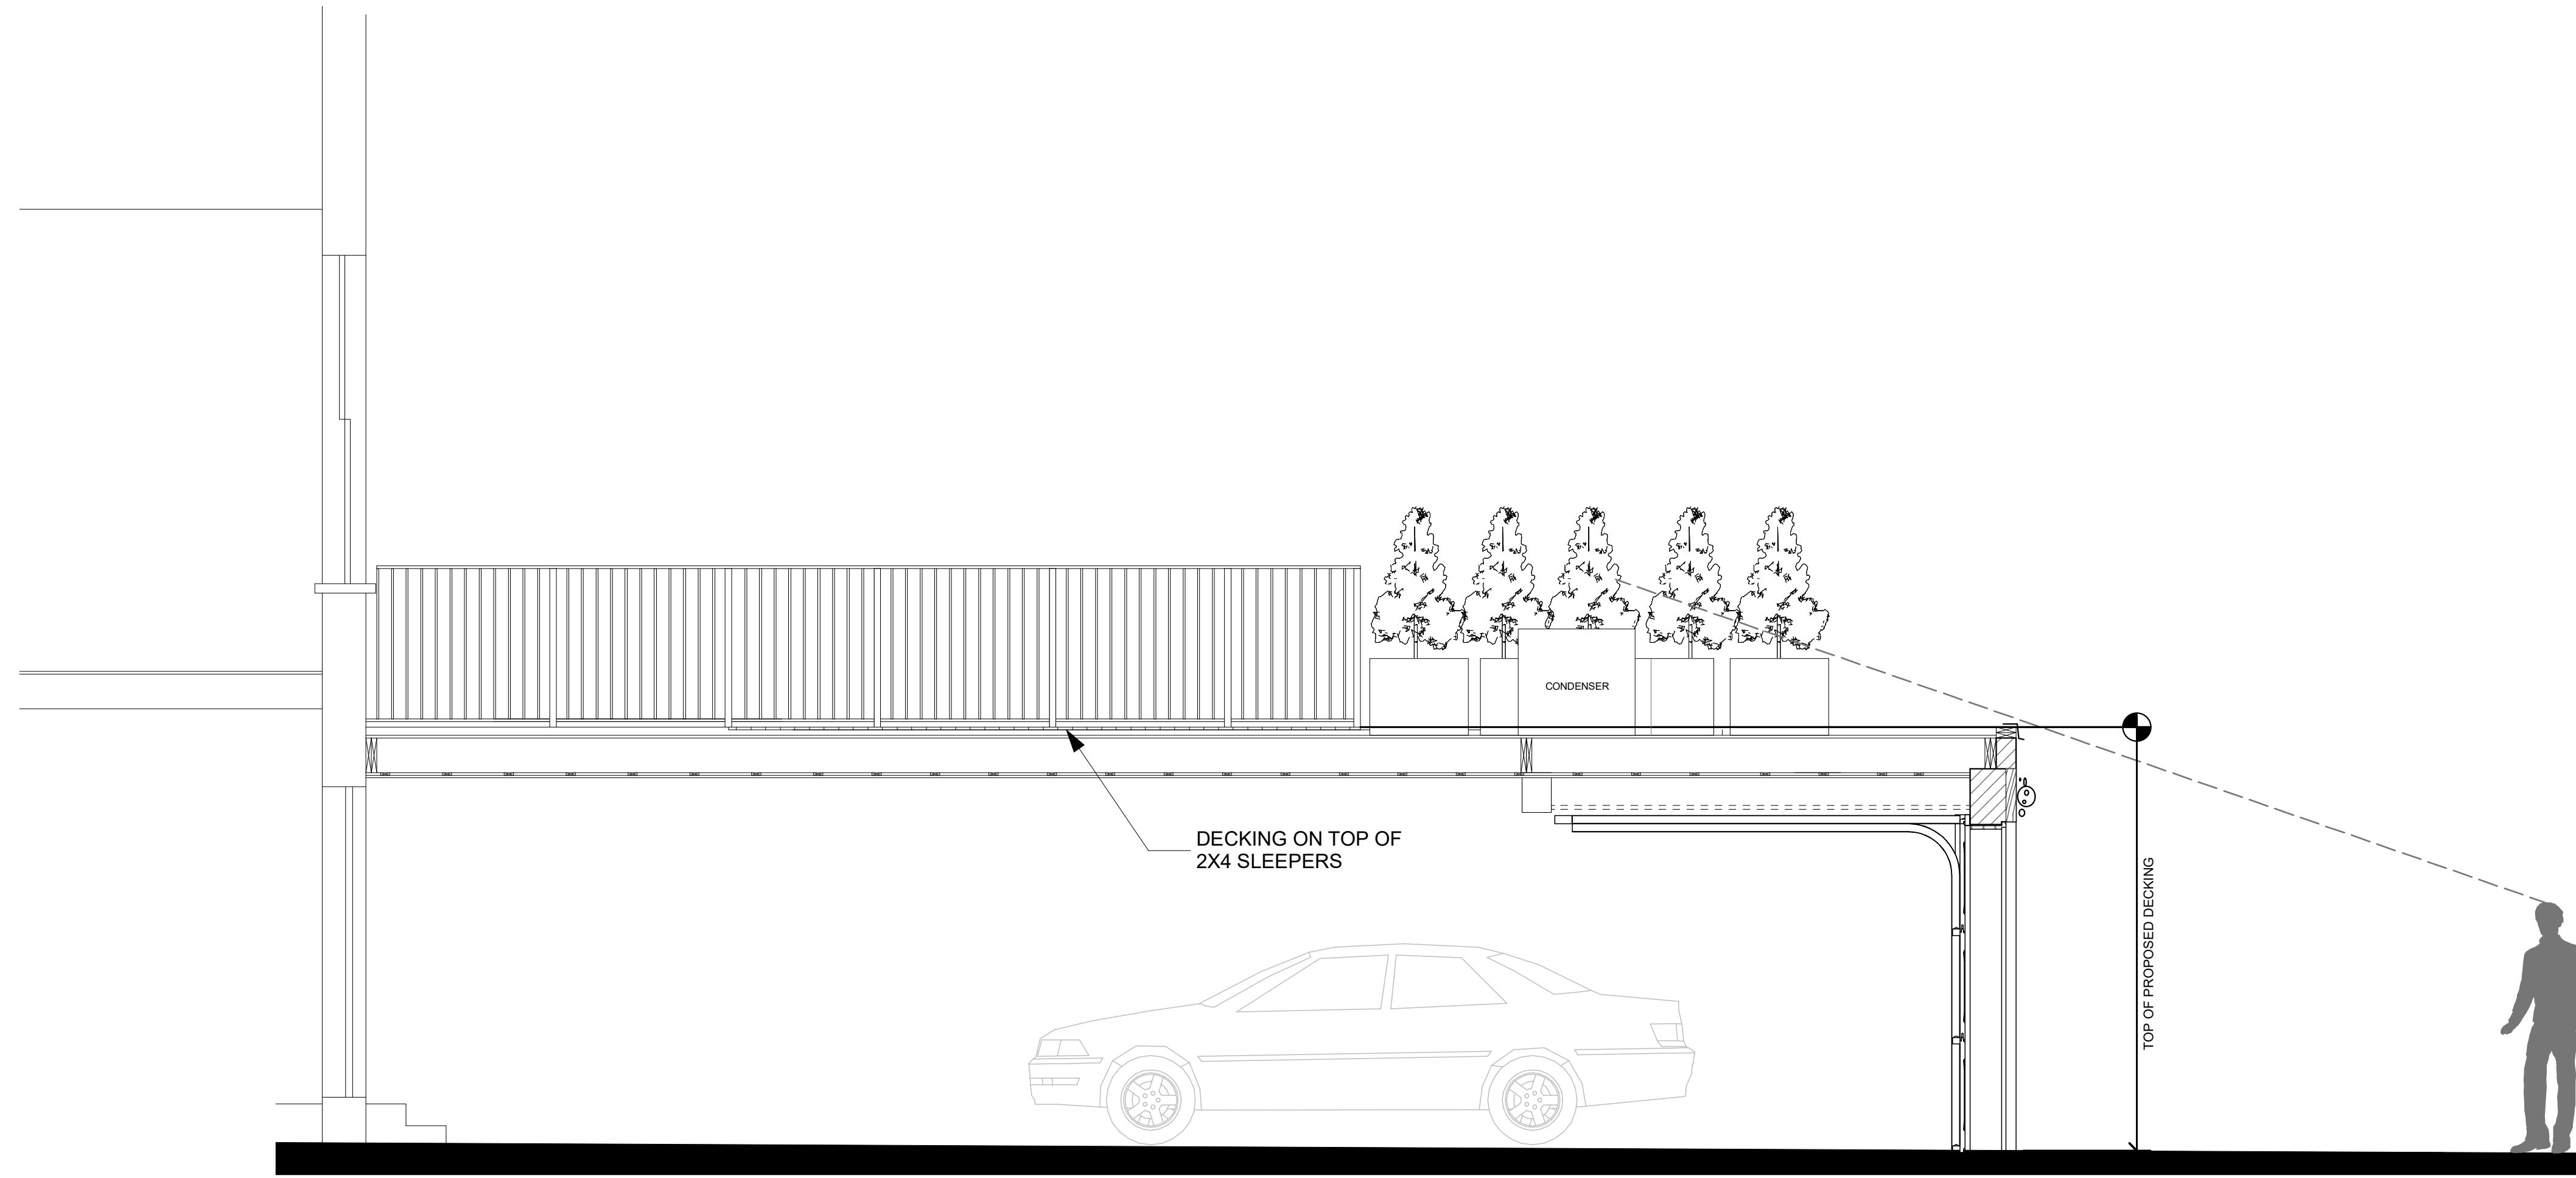

**SECTION**  
SCALE: 3/8" = 1'-0"

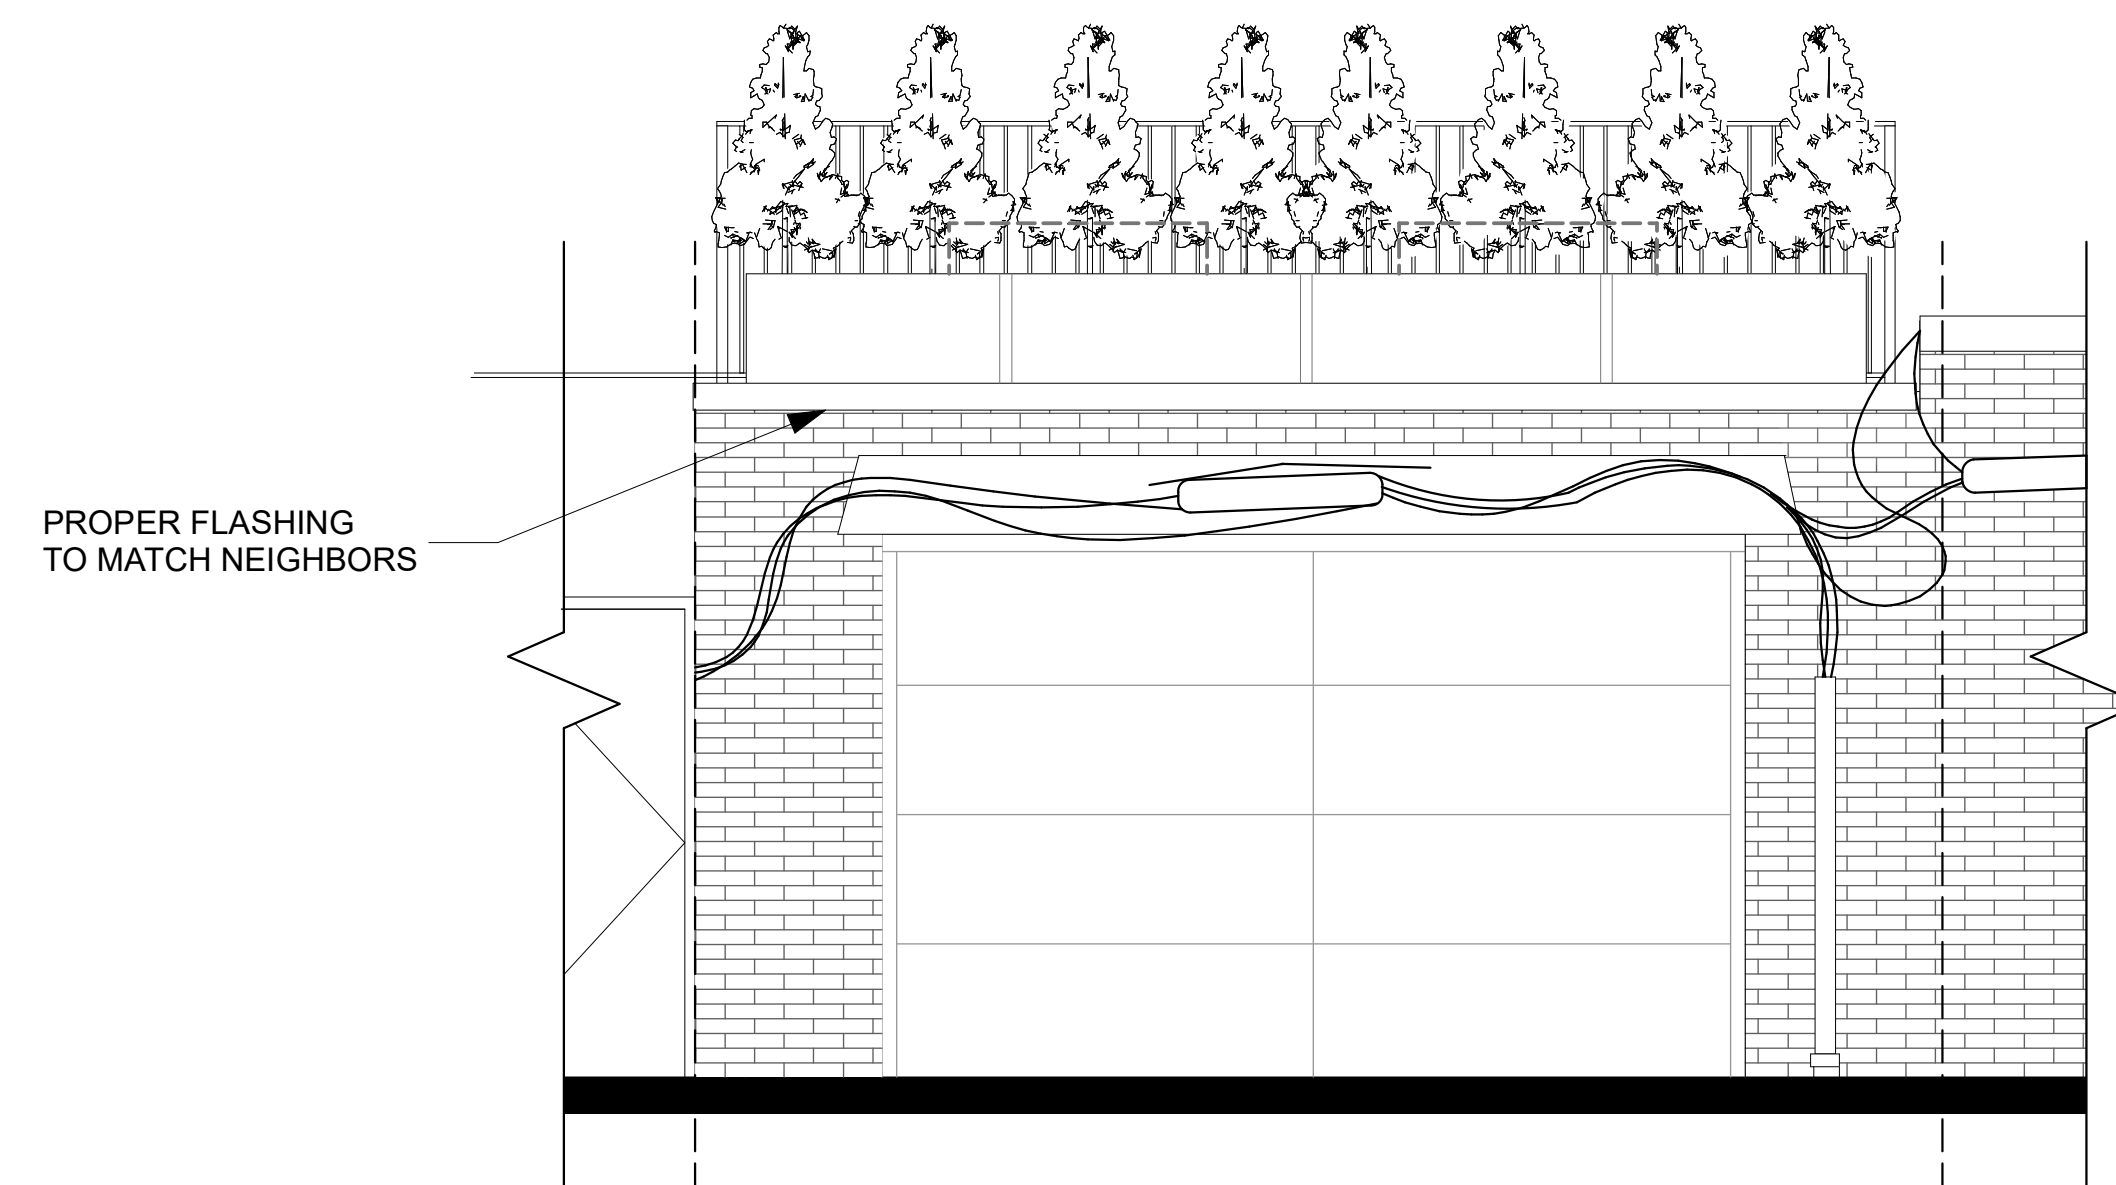

**ELEVATION**  
SCALE: 3/8" = 1'-0"

PAGE INFORMATION:  
**DRAWINGS**

REVISION/DATE

PRINT DATE:  
**10/23/2019**

ISSUE DATE:  
**#Issue Date**

PROJECT NAME:  
**60 Chestnut Street**

PROJECT ADDRESS:  
**60 Chestnut Street  
Boston, Ma**